

D

C

B

A


REVISIONS	
REV.	COMMENT
01	RELEASE PER EC-03359
02	RELEASE PER EC-03364.
03	RELEASE PER EC-03427 ; CHANGES NOTED WITH 

D

1. MARK VENDOR NAME, LABEL DESIGNATION, AND SOMA NETWORKS PART NUMBER ON EACH SHEET OF LABELS.
2. BACKGROUND TO BE DARK GRAY (PANTONE COLOR 432C) LETTERING AND GRAPHICS TO BE SILVER.
3. REFER TO APPROPRIATE AGENCY LISTING MARK INFORMATION TO REPLACE REFERENCE SYMBOLS WITH APPROPRIATE REGISTERED MARKS.
4. FONT: ARIAL 24 POINT
5. FONT: ARIAL NARROW 18 POINT
6. FONT: ARIAL 10 POINT
7. FONT: ARIAL 6 POINT
8. FONT: ARIAL 5 POINT
9. LABEL CONSTRUCTION TO CONSIST OF A 0.010" THICK POLYCARBONATE LABEL STOCK WITH A 0.002" THICK 3M #467 PRESSURE SENSITIVE ADHESIVE. SOMA ENGINEERING APPROVED MATERIALS MAY BE SUBSTITUTED. LABEL MUST BE A COMPONENT MARKING AND LABELING SYSTEM APPROVED BY UL AND CSA FOR THE FOLLOWING CONDITIONS:

- A) INDOOR
- B) TEMPERATURE RANGE: -40C TO +55C WHEN AFFIXED TO GE CYCOLOY C6200 (PC/ABS BLEND)

10. PRINT "FCC ID: POZCPEPCS004886C" AT NOTED LOCATION.
11. NOT USE.
12. PRINT "LISTING # E112355" AT NOTED LOCATION.
13. PLACE MET LOGO (MET1US.GIF) IN NOTED LOCATION.
14. FONT: ARIAL NARROW 6 POINT

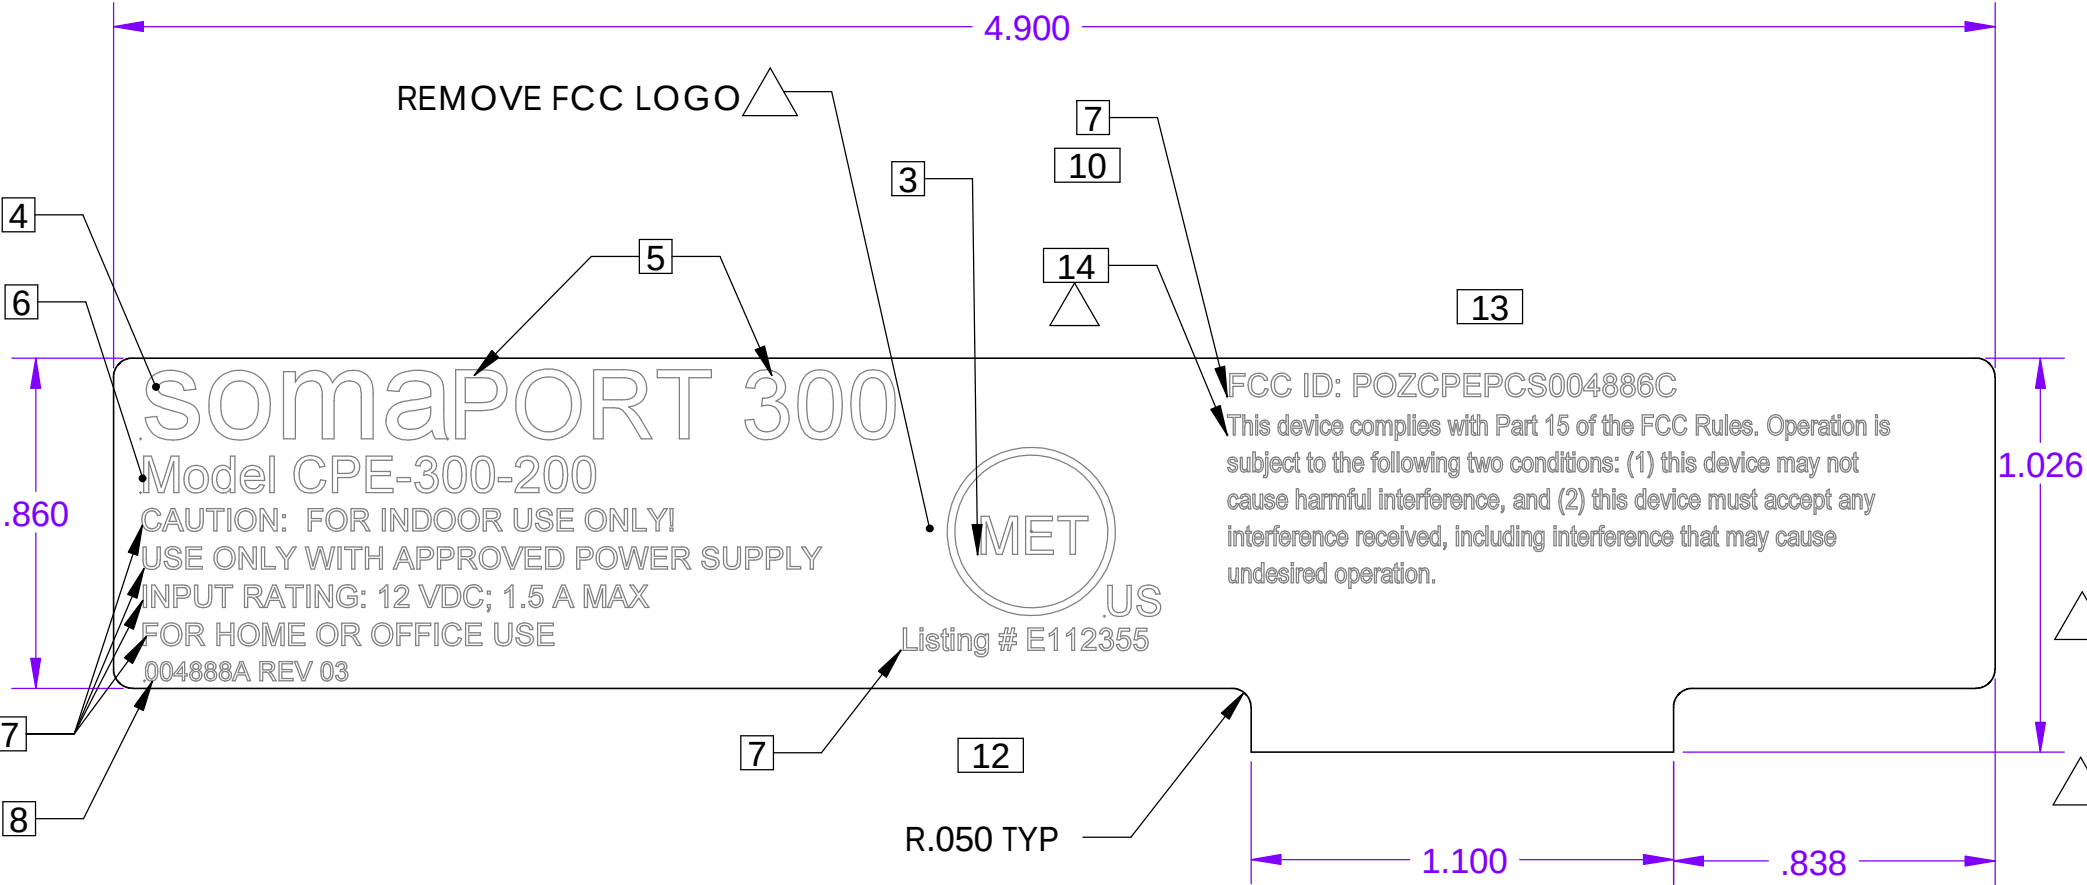

DRAWING SCALE 2:1

TITLE:
LABEL,REGULATORY,USA,SP3,PCS [SOMAPORT 300 MODEL CPE-300-200],PRE-PRINTED

	UNLESS OTHERWISE SPECIFIED:			DIMENSIONS ARE IN INCHES		PROPRIETARY AND CONFIDENTIAL THE INFORMATION CONTAINED IN THIS DRAWING IS THE SOLE PROPERTY OF SOMA NETWORKS, INC. ANY REPRODUCTION IN PART OR AS A WHOLE WITHOUT THE WRITTEN PERMISSION OF SOMA NETWORKS IS PROHIBITED.	
	MATERIAL: 9			TOLERANCES: ANGULAR: ±1°			
	FINISH:			ONE PLACE DECIMAL ±.1 TWO PLACE DECIMAL ±.01 THREE PLACE DECIMAL ±.005			
		NAME	DATE	SIZE	DWG. NO.	REV	
	DRAWN	thnguyen	9/8/2004	B	004888A	03	
	ENG APPR.		9/8/2004	SCALE: 1:1		DO NOT SCALE DRAWING	SHEET 1 OF 1

MODEL FILE: 004888A.SLDPRT/REV01

1

1

SH

REV

004888A



DWG. NO.

A


REVISIONS	
REV.	COMMENT
01	INITIAL RELEASE PER EC-03353

NOTES: (UNLESS OTHERWISE SPECIFIED)

1. ASSEMBLE UNIT PER INSTRUCTIONS BELOW (NOTES 2-7):
2. TORQUE SCREW, ITEM 8, TO 8±1 IN-LBS.
3. ASSEMBLE ITEMS 4 AND 5, EMI CONTACTS TO RIGHT AND LEFT, INTO PINS OF THE ITEM 2, BOTTOM CASE. PRESS DOWN UNTIL SURFACES MEET.
4. SLIDE ITEM 1, CHASSIS/PCA ASSEMBLY, INTO ITEM 2, BOTTOM CASE. FOUR HOLES IN ITEM 1 ALIGN WITH HOLES IN ITEM 2.
5. PLACE ITEM 3, TOP CASE, OVER ITEM 2, BOTTOM CASE. ASSEMBLE ITEM 3 TO THE ITEM 1, CHASSIS/PCA ASSEMBLY, AND ITEM 2, BOTTOM CASE, USING SCREWS, ITEMS 8 (4X).
6. PLUG RUBBER FEET, ITEMS 12 (4X), INTO HOLES IN BOTTOM OF ITEM 2. PRESS IN UNTIL SURFACES MEET.
7. PLACE ITEM 9, REGULATORY LABEL, AND ITEM 10, SERIAL NUMBER LABEL, IN DETENT ON BOTTOM OF ITEM 2. LABELS TO BE APPROXIMATELY .020 IN FROM EDGE OF LABEL DETENT AND APPROXIMATELY .060 IN FROM EACH OTHER.

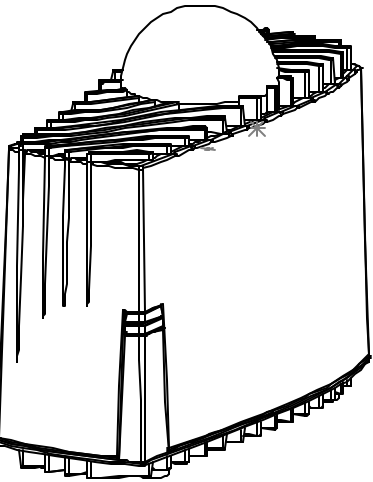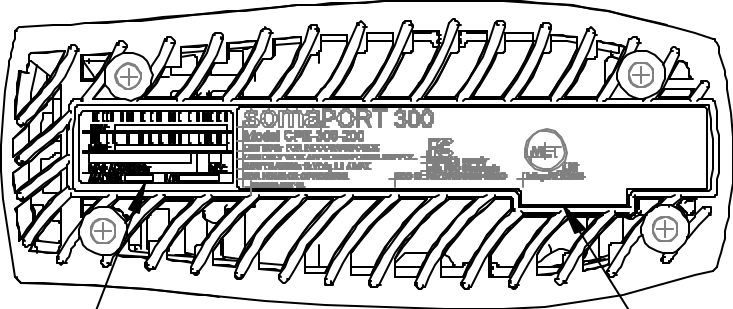

ASSEMBLED VIEW

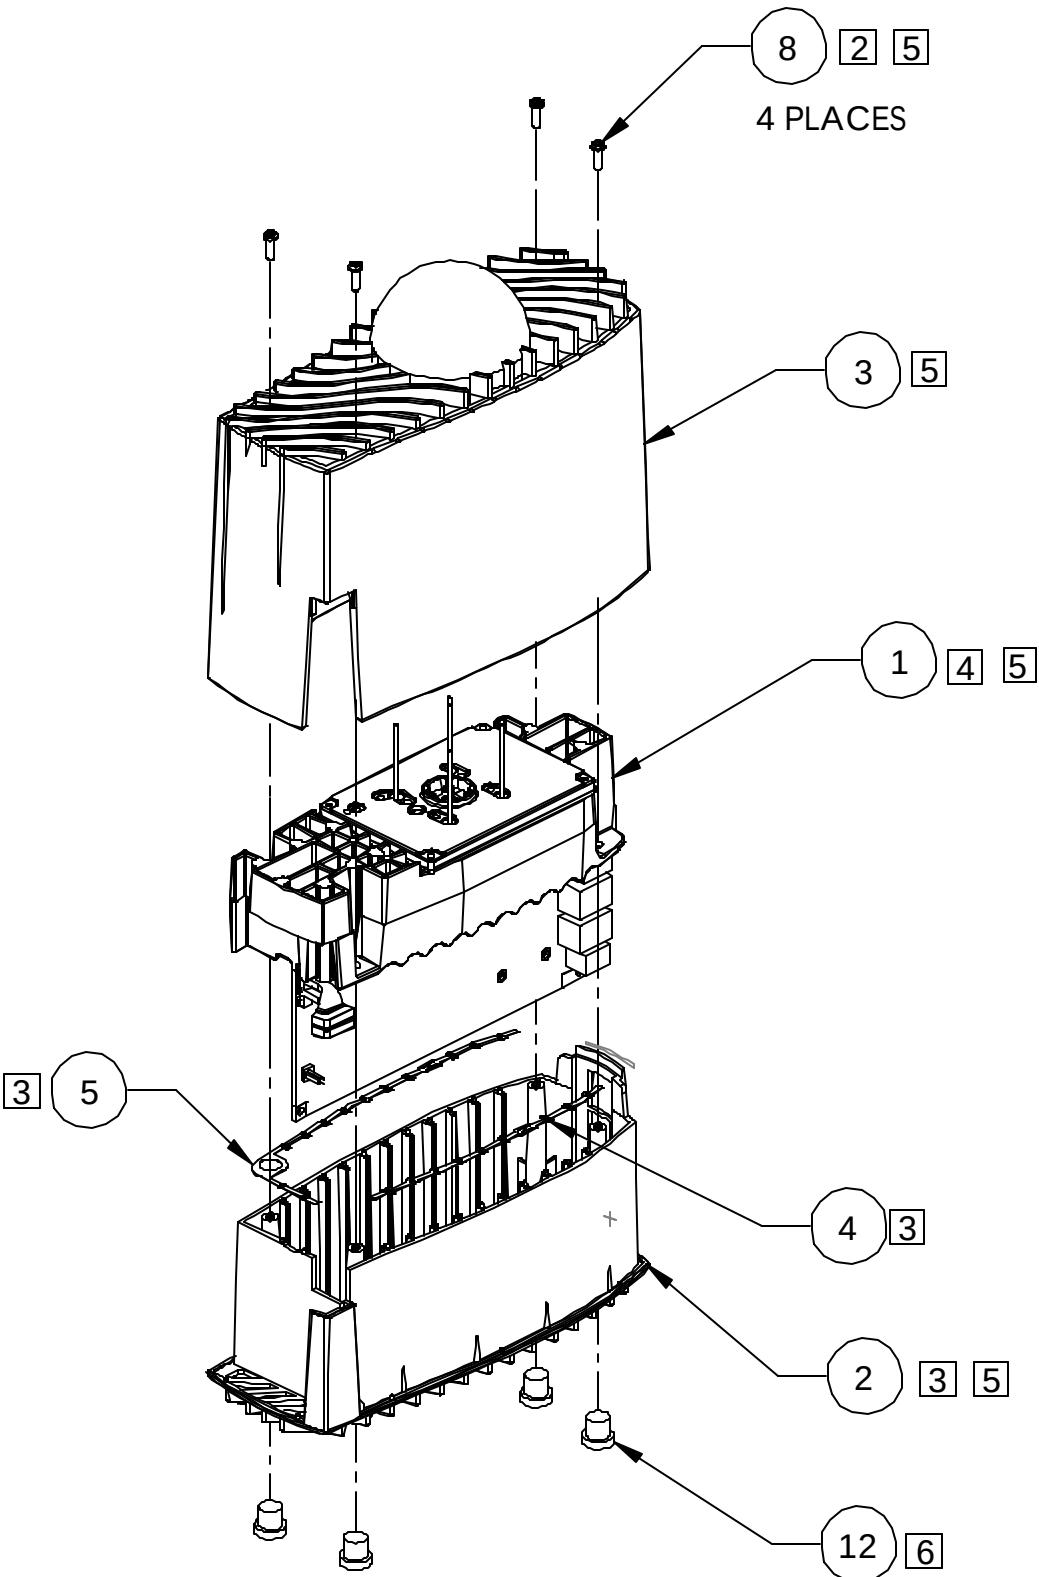

EXPLODED VIEW

TITLE:

ASSY DWG MX,SYSTEM,SP3



UNLESS OTHERWISE SPECIFIED:			DIMENSIONS ARE IN INCHES		PROPRIETARY AND CONFIDENTIAL THE INFORMATION CONTAINED IN THIS DRAWING IS THE SOLE PROPERTY OF SOMA NETWORKS, INC. ANY REPRODUCTION IN PART OR AS A WHOLE WITHOUT THE WRITTEN PERMISSION OF SOMA NETWORKS IS PROHIBITED.	
MATERIAL:			TOLERANCES:			
FINISH:			ANGULAR: ±1°			
			ONE PLACE DECIMAL ±.1			
			TWO PLACE DECIMAL ±.01			
			THREE PLACE DECIMAL ±.005			
	NAME	DATE	SIZE	DWG. NO.		REV
DRAWN	thnguyen	8/12/2004	B	ADM-000057		01
ENG APPR.	bbonn	8/12/2004	SCALE: 1:3		DO NOT SCALE DRAWING	SHEET 1 OF 1

MODEL FILE: SP3_ASM_TRI.SLDPRT/REV05