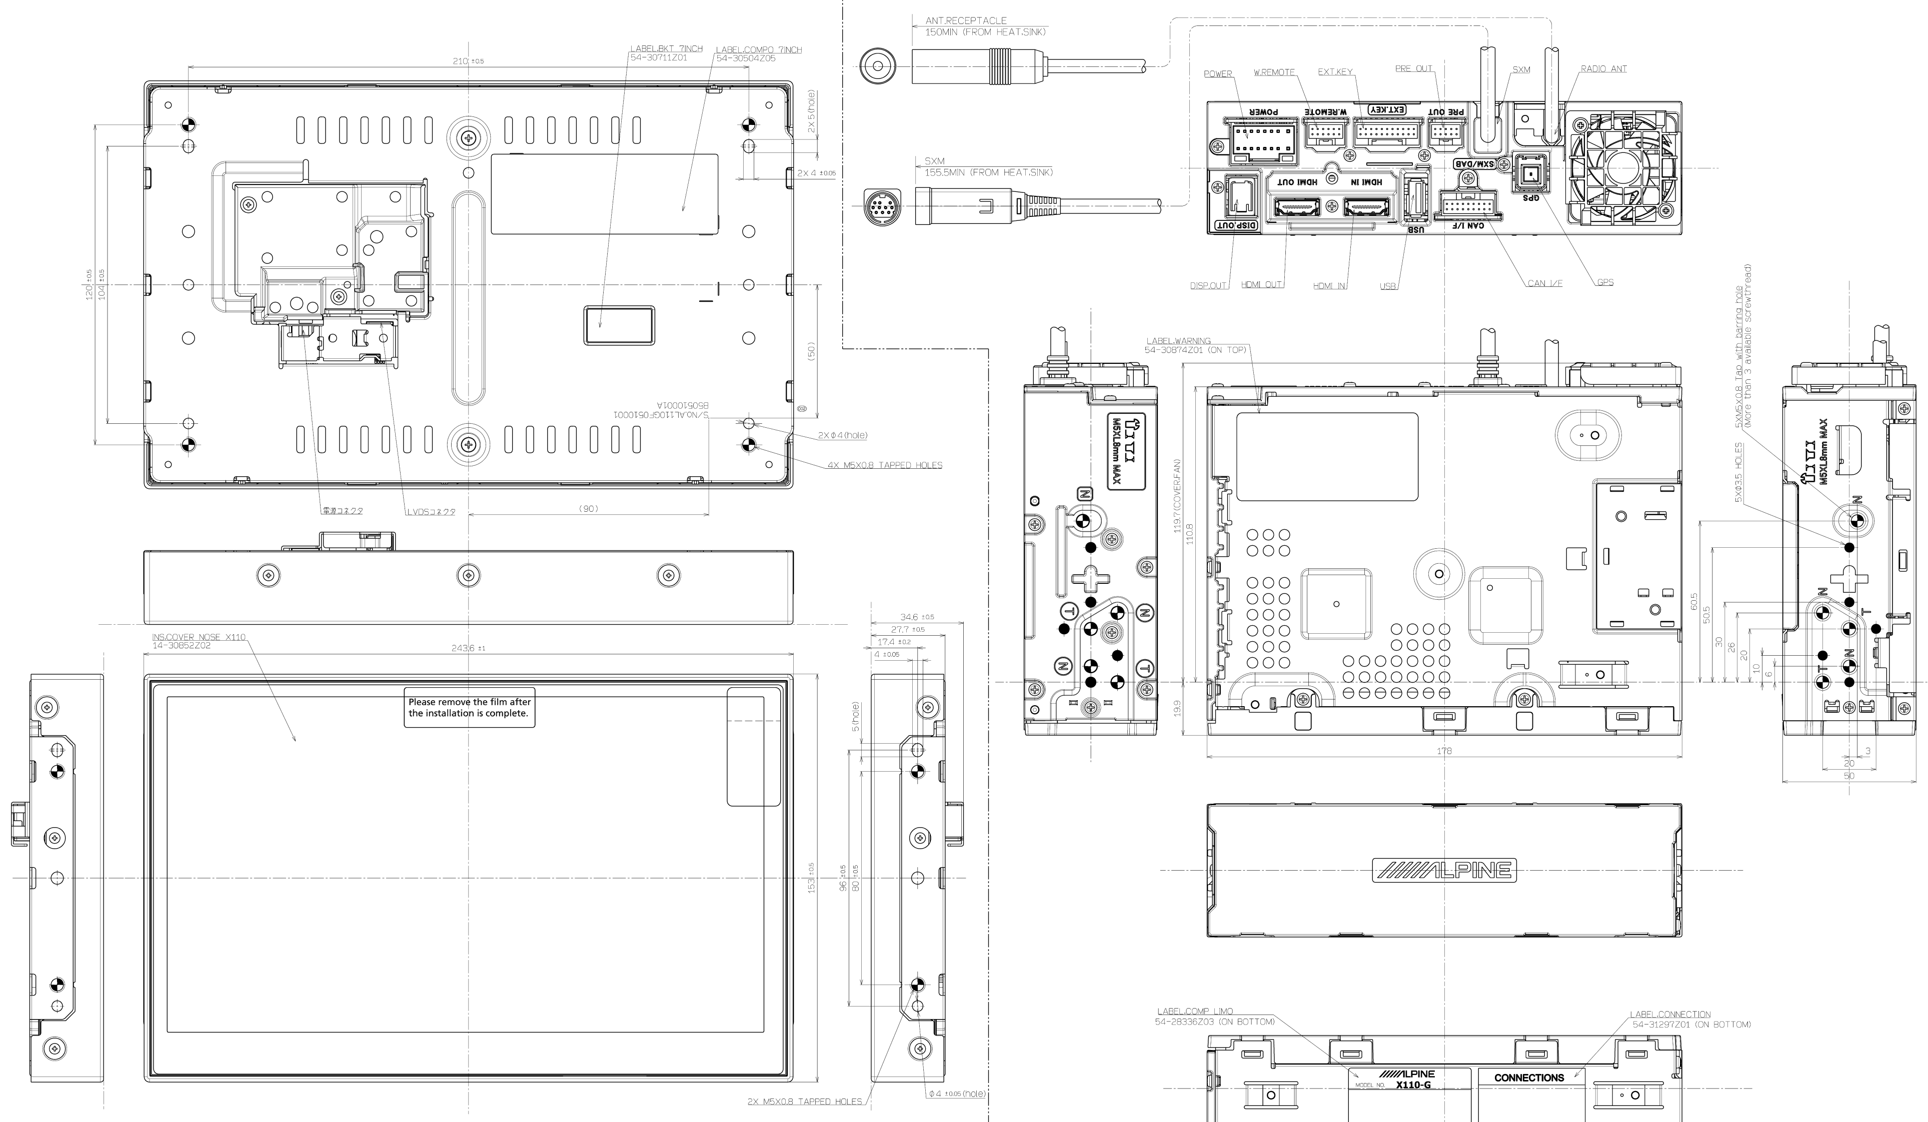

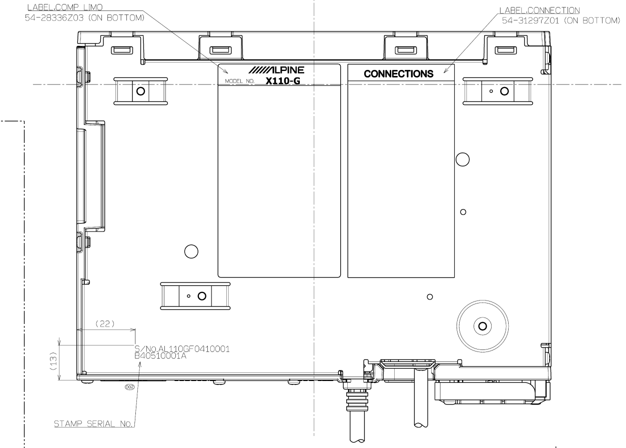

-- NOTES --

1.STAMP SERIAL No. PRINT WITH BLACK INK ON THE LABEL.
SERIAL No. WITH EIGHT DIGITS NUMBER AS FOLLOWS.

(002) B 5 04 10001 A

- A: MANUFACTURING CONTROL NUMBER. [製造密番：無印から始まりサービス課の指示によりA,B,Cの順で変更する。]
- 10001: SERIAL No. WOULD BE CONSECUTIVE NUMBER FROM 10001 UP TO 99999 AND THEN REPEAT SERIES. [連番：10001から99999迄の繰り返し]
- 04: TWO DIGIT OF THE MONTH. EX. 01-JAN , 05-MAY , 12-DE. [製造月：01-1月 , 05-5月 , 12-12月.]
- 5: LAST DIGIT OF THE YEAR. [西暦年号の下一桁：例 2015-5 , 2016-6]
- B: SIGN OF PRODUCT FACTORY NAME. EX. H:AOIW-YS, B:AOIW-ON,S-DDA ,T-AODL ,E-AOTA [生産工場名表示記号 例：H:AOIW-YS, B:AOIW-ON ,S-DDA ,T-AODL ,E-AOTA]

2.LABEL BAR-CODE

NL00001AB50410001A
表示モデル名 NL00001A
(002) SERIAL No. (NOTE 1.参照)

QL00001AB50410001A
表示モデル名 QL00001A
(002) SERIAL No. (NOTE 1.参照)

3.PACKING
FOUR INDIVIDUALLY PACKED UNITS ARE TO BE PACKED ONE MASTER.

4.UPC-CODE IS PRINTED ON THE CARTON PACKING(IND)
CODE No. 793276210937

	68-29530Z49	C/N.CAUTION HI-TEMP	1
	68-29530Z13	QRG.X110_LIMO-10 US	1
(002)	~~68-29530Z31~~	~~C/N LEAF AOIW~~	~~1~~
	68-21627Z32	C/S-USA AOAM AOIW	1
	68-29530Z26	C/N.NAVICARD LIMO US	1
(002)	68-29530Z73	C/N.URL X110_LIMO US	1
	CONTENT CODE	CONTENT NAME	QTY
	PAMPHLET		

09-30497Z02	ASSY.ANIC-0089-01A	1
09-31165Z01	ASSY.ANID-0208-01A	1
09-31130Z01	ASSY.ANID-0202-01A	1
09-31132Z01	ASSY.ANID-0204-01A	1
09-31131Z01	ASSY.ANID-0203-01A	1
85-11368Z04	ASSY.YOP-5245AL06	1
09-22649Z02	ASSY.ANID-0179-02A	1
03S60820Y16	SCR.MCH 5X8 ZN A	4
03S60820Y17	SCR.MCH 5X8 ZN A	8
07-30181Z01	BKT.HDMI ASSY	1
CONTENT CODE	CONTENT NAME	QTY
KIT		

UNIT --- MM | SCALE 1 : 1
THIRD ANGLE ORTHOGRAPHIC PROJECTION
OWNERSHIP OF TOOL ☐Y ☒N
REVISIONS INDICATED BY CIRCLED LETTERS

ATS4
DIVISIONS | L<=30 | 30<L<=120 | 120<L
TOLERANCE | ±0.15 | ±0.25 | ±0.4
ALL RIGHT ANGLE BENDS | ±1°

CONTENT DESCRIPTION (FINISH OR PROCESSING) ---
MATERIAL OR SOURCE OF CONTENT --
MATERIAL TEMPER OR HARDNESS --
CONTENT CODE -- | ISSUE --
T-DOCUMENT NAME O/L ,WL00001A

WL00001A-00
T-DOCUMENT CODE
GROUP CATIA V5 | SUB GROUP -------

ISSUE	RELEASES AND REVISIONS MEMO (DRAWN BY)/(CHECKED BY)/(APPROVED BY)
001	RELEASED FOR PRODUCTION 02-20-'15
002	CF151055-GK 05-15-'15 Change product factory name.(A-5, B-5, B-6, C-2, D-6). Change PAMPHLET. Change 68-16340Z15 → 68-29530Z73(D-5). Delete 68-29530Z31(D-5). K.NISHI / N.SANO / N.SANO

ALPINE ELECTRONICS, INC.

APPROVED BY N.SANO | CHECKED BY N.SANO | DRAWN BY Y.SATO

PRODUCT CODE WL00001A

WL00001A-00
T-DOCUMENT CODE

A1

DFM101-01