/home/cdrdata/umms/mfc.cab/schematics/1.drw 18 APR 98 11:50 last update: 18 APR 98 11:48

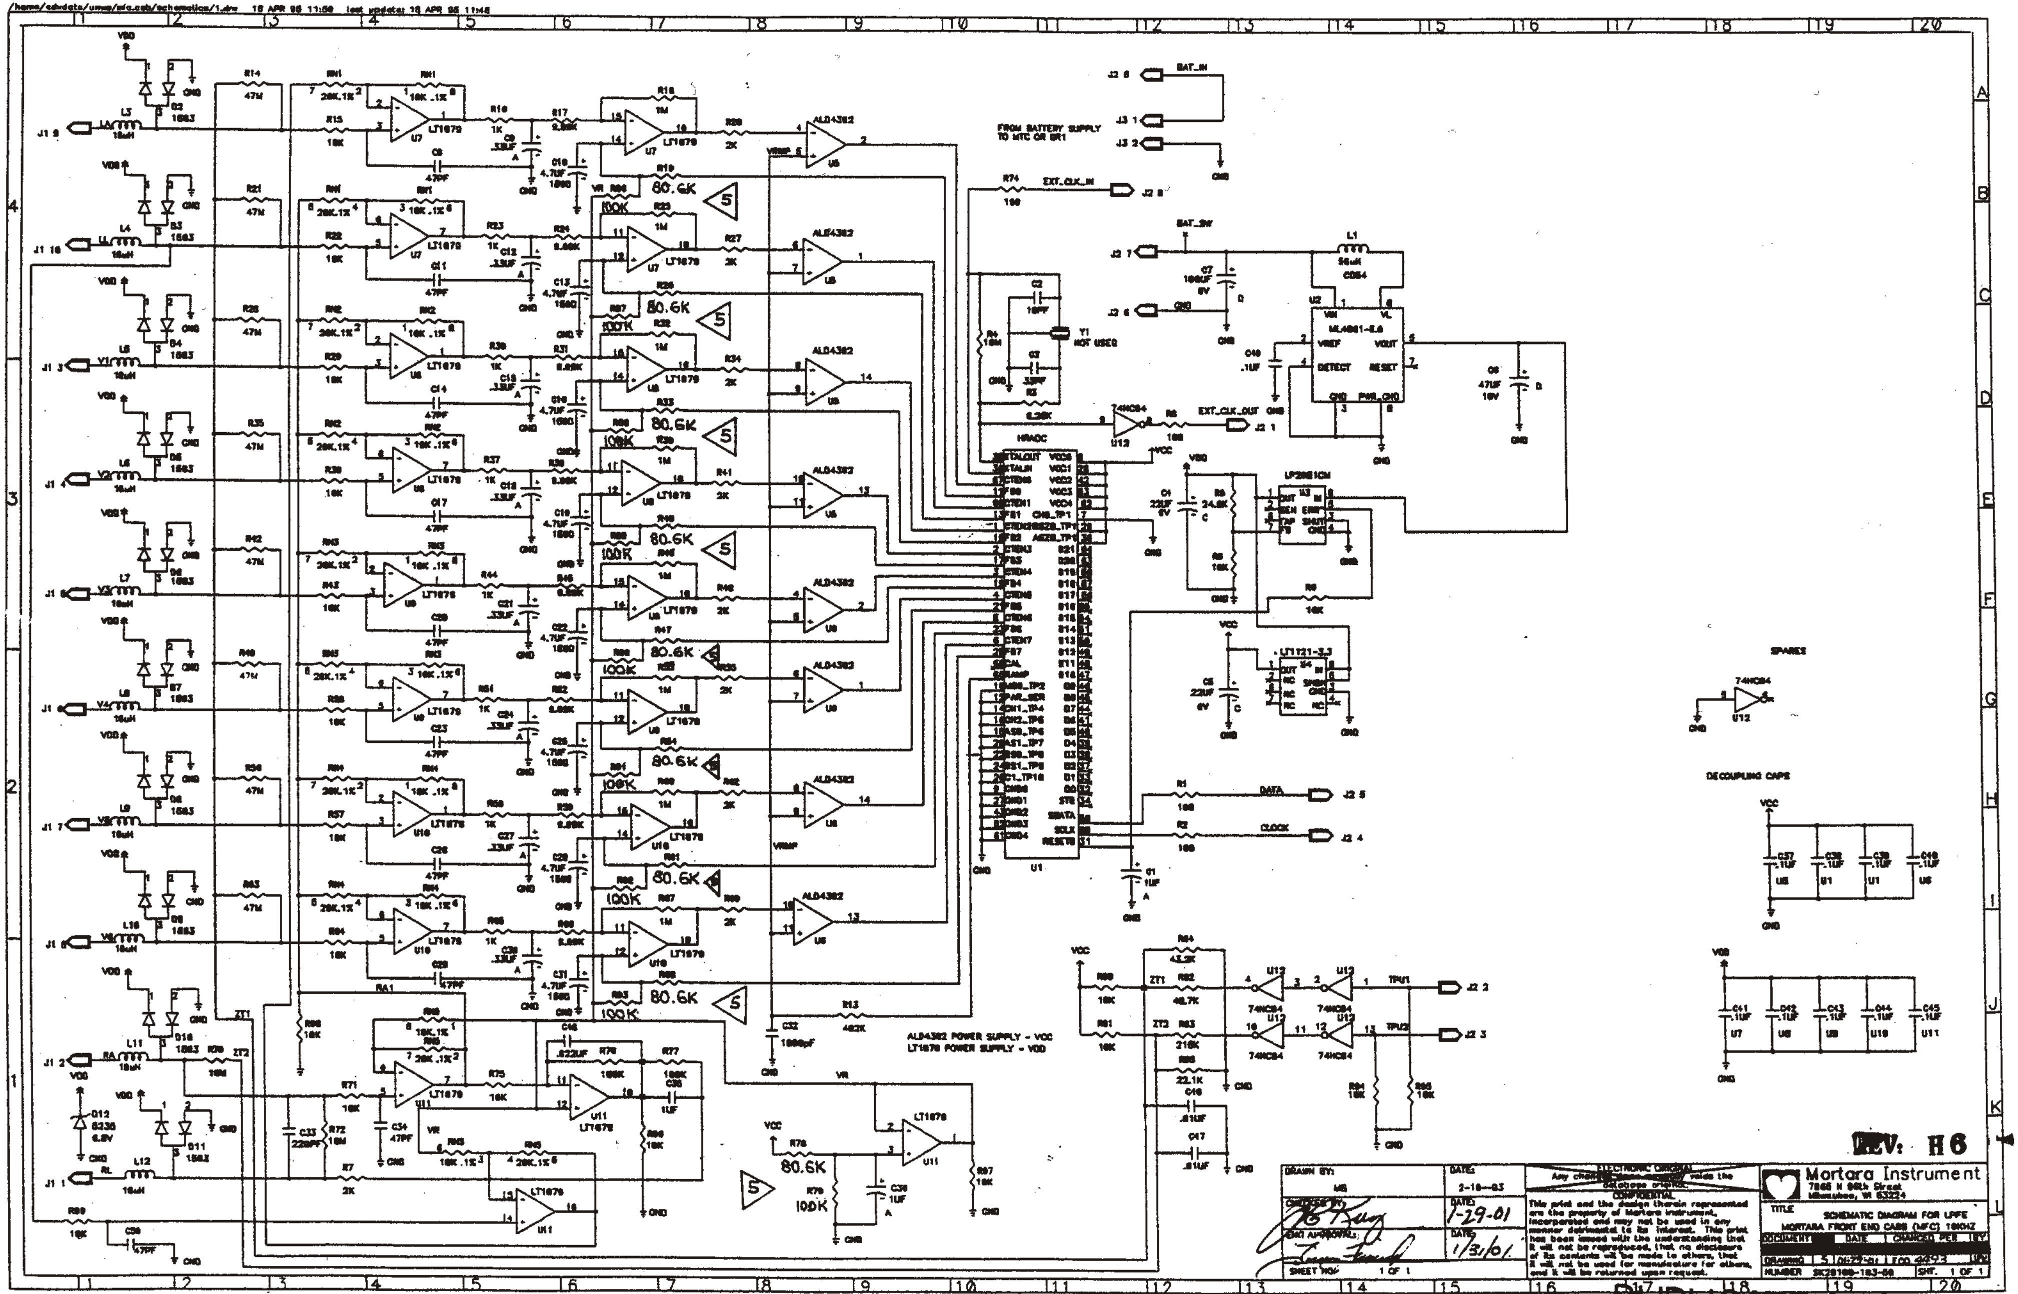

REV: H6

DRAWN BY:
MB
DATE:
2-16-93
CHECKED BY:
DATE:
1-29-01
ENG APPROVAL:
DATE:
1/3/01.
SHEET NO:
1 OF 1

~~ELECTRONIC ORIGINAL~~
~~Any change to this drawing voids the database original.~~

CONFIDENTIAL
This print and the design therein represented are the property of Mortara Instrument, Incorporated and may not be used in any manner detrimental to its interest. This print has been issued with the understanding that it will not be reproduced, that no disclosure of its contents will be made to others, that it will not be used for manufacture for others, and it will be returned upon request.

Mortara Instrument
7865 N 86th Street
Milwaukee, WI 53224

TITLE
SCHEMATIC DIAGRAM FOR LPFE
MORTARA FRONT END CABS (MFC) 10KHZ

DOCUMENT	DATE	CHANGED PER	BY
[redacted]	[redacted]	[redacted]	[redacted]

DRAWING NUMBER 9K28100-183-00 | 5 | 06/29/01 | ECO 4993 | [illegible]
SHT. 1 OF 1

DUPLICATE ORIGINAL